


Proposed Amendment to School Base Plan A.1  
 Red line = Base Plan A.1

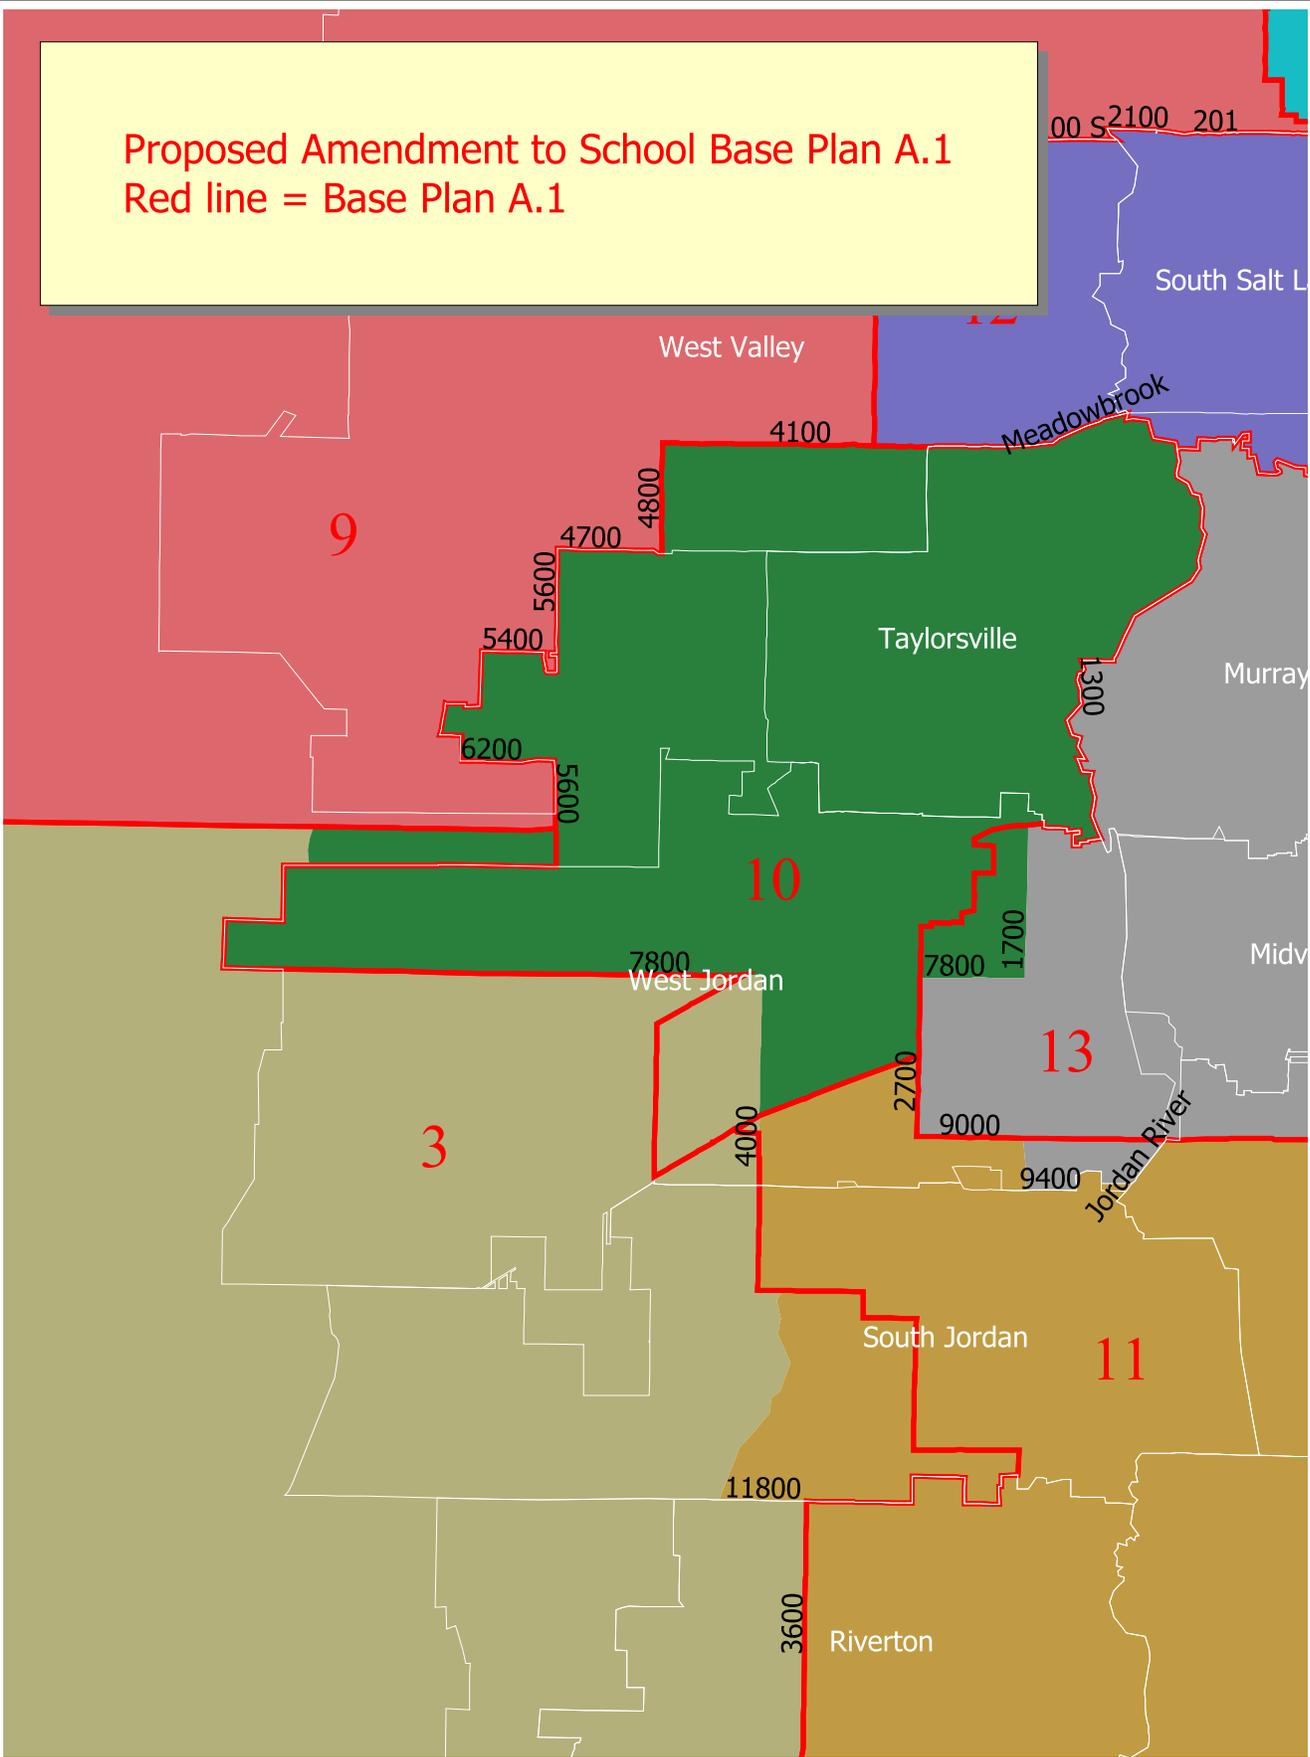

 Counties  
 Cities  
 Districts  
 Voting Precincts

State School Board Redistricting  
 Proposed Amendment to Base Plan A.1  
 Office of Legislative Research and General Counsel